

MIAMI-DADE COUNTY PRODUCT CONTROL SECTION

11805 SW 26 Street, Room 208 Miami, Florida 33175-2474 T (786) 315-2590 F (786) 315-2599

www.miamidade.gov/economy

DEPARTMENT OF REGULATORY AND ECONOMIC RESOURCES (RER) BOARD AND CODE ADMINISTRATION DIVISION

NOTICE OF ACCEPTANCE (NOA)

Quality Engineered Products Co., Inc. 4506 Quality Lane Tampa, FL 33634

SCOPE:

This NOA is being issued under the applicable rules and regulations governing the use of construction materials. The documentation submitted has been reviewed and accepted by Miami-Dade County RER -Product Control Section to be used in Miami Dade County and other areas where allowed by the Authority Having Jurisdiction (AHJ).

This NOA shall not be valid after the expiration date stated below. The Miami-Dade County Product Control Section (In Miami Dade County) and/or the AHJ (in areas other than Miami Dade County) reserve the right to have this product or material tested for quality assurance purposes. If this product or material fails to perform in the accepted manner, the manufacturer will incur the expense of such testing and the AHJ may immediately revoke, modify, or suspend the use of such product or material within their jurisdiction. RER reserves the right to revoke this acceptance, if it is determined by Miami-Dade County Product Control Section that this product or material fails to meet the requirements of the applicable building code.

This product is approved as described herein, and has been designed to comply with the Florida Building Code, including the High Velocity Hurricane Zone.

DESCRIPTION: Series 16 ga Outswing Single Flush Commercial Steel Door-Impact

APPROVAL DOCUMENT: Drawing No. **QEP002**, titled "Single Flush Door (Outswing)", sheets 1 through 7of 7, prepared by manufacturer, dated 10/05/09, signed and sealed by David M. Schonacher, P. E., bearing the Miami-Dade County Product Control Revision stamp with the Notice of Acceptance number and expiration date by the Miami-Dade County Product Control Section.

MISSILE IMPACT RATING: Large and Small Missile Impact Resistant

Limitation: 1. Doors are 16 ga (.062" thk) min with min Tensile yield strength of 43.0 ksi.

- 2. Doors w/ cylindrical lock & standard reinforced are rated at +/- 80 psf
- 3. Doors w/ Mortise loc+ bolt & Hat Channel reinforced are rated at +/- 110 psf
- 4. Approved EPS core by Dynaplast (Former Apache) or Carpenter Co. having current NOA

LABELING: Each unit shall bear a permanent label with the manufacturer's name or logo, city, state and series and following statement: "Miami-Dade County Product Control Approved", noted herein.

RENEWAL of this NOA shall be considered after a renewal application has been filed and there has been no change in the applicable building code negatively affecting the performance of this product.

TERMINATION of this NOA will occur after the expiration date or if there has been a revision or change in the materials, use, and/or manufacture of the product or process. Misuse of this NOA as an endorsement of any product, for sales, advertising or any other purposes shall automatically terminate this NOA. Failure to comply with any section of this NOA shall be cause for termination and removal of NOA.

ADVERTISEMENT: The NOA number preceded by the words Miami-Dade County, Florida, and followed by the expiration date may be displayed in advertising literature. If any portion of the NOA is displayed, then it shall be done in its entirety.

INSPECTION: A copy of this entire NOA shall be provided to the user by the manufacturer or its distributors and shall be available for inspection at the job site at the request of the Building Official.

This NOA revises NOA # 09-0604.09 and consists of this page 1 and evidence pages E-1, as well as approval document mentioned above.

The submitted documentation was reviewed by Ishaq I. Chanda, P.E.

MIAMI-DADE COUNTY
APPROVED

NOA No. 12-1115.09 Expiration Date: December 30, 2014 Approval Date: January 31, 2013

Page 1

Quality Engineered Products Co, Inc.

NOTICE OF ACCEPTANCE: EVIDENCE SUBMITTED

A. DRAWINGS

- 1. Manufacturer's die drawings and sections (Submitted under file # 09-0604.10)
- 2. Drawing No. **QEP002**, titled "Single Flush Door (Outswing)", sheets 1 through 7 of 7, prepared by manufacturer, dated 10/05/09, signed and sealed by David M. Schonacher, Jr., P. E.

B. TESTS (Submitted under file # 09-0604.10)

- 1. Test reports on 1) Air Infiltration Test, per FBC TAS 202-94
 - 2) Uniform Static Air Pressure Test, Loading per FBC, TAS 202.
 - 3) Water Resistance Test per FBC, TAS 202-94 (Not Performed).
 - 4) Large Missile Impact Test per FBC, TAS 201-94
 - 5) Cyclic Wind Pressure Loading per FBC, TAS 203-94
 - 6) Forced Entry Test, per FBC and TAS 202-94

Along with marked-up drawings and installation diagram of Single Outswing /Inswing Flush and Glazed Commercial Steel Doors, prepared by Architect Testing Lab Inc., Test Report No. **84528.01-401-18**, dated May 19, 2009 (This test report was last revised on 11/06/09), signed and sealed by Joseph A. Reed, P.E.

C. CALCULATIONS

1. Anchor verification calculations, dated 06/15/2009 and last revised on 10/28/2009, prepared, signed and sealed by David M. Schonacher, Jr., P.E. (Submitted under file # **09-0604.10**).

D. QUALITY ASSURANCE

Miami Dade Department of Regulatory and Economic Resources (RER)

E. MATERIAL CERTIFICATIONS

- 1. Tensile test report prepared by prepared by Architect Testing, Test Report No. **84528.01-401-18**, tested per ASTM E8-03, dated 11/09/09 signed and sealed by Joseph A. Reed, P. E. (Submitted under file # **09-0604.10**)
- 2. Notice of Acceptance No. **11-0926.07** issued to Dyplastic Products, LLC (former Apache Products Co) for "EPS-Expanded Polystyrene Insulation", expiring on 01/11/2017.
- 3. Notice of Acceptance No. **11-1222.01** issued to Carpenter Company for "EPS-Expanded Polystyrene Insulation", expiring on 04/11/17.

F. STATEMENTS

- 1. Statement letter of conformance to FBC 2010 and "no financial interest", dated 01/15/13, signed and sealed by David M. Schonacher Jr., P. E.
- 2. Statesman letter of conformance to FBC 2007 and "No financial interest", dated 06/15/09, signed and sealed by David M. Schonacher Jr., P. E. (Submitted under file # **09-0604.10**)
- 3. Statement letter of compliance, as a part of the above referenced test reports.

G. OTHER

1. This **revises NOA # 09-0604.10**, expiring December 30, 2014.

Ishaq I. Chanda, P.E. Product Control Examiner

NOA No. 12-1115.09

Expiration Date: December 30, 2014 Approval Date: January 31, 2013

INSTALLATION NOTES:

- ONE (1) INSTALLATION ANCHOR IS REQUIRED AT EACH ANCHOR LOCATION SHOWN.
- THE NUMBER OF INSTALLATION ANCHORS **DEPICTED IS THE MINIMUM NUMBER OF ANCHORS** TO BE USED FOR PRODUCT INSTALLATION.
- SHIM AS REQUIRED AT EACH INSTALLATION ANCHOR WITH LOAD BEARING SHIM(S). MAXIMUM 1. ALLOWABLE SHIM STACK TO BE 1/4 INCH. SHIM WHERE SPACE OF 1/16 INCH OR GREATER OCCURS. SHIM(S) SHALL BE CONSTRUCTED OF HIGH DENSITY PLASTIC OR BETTER.
- FOR INSTALLATION THROUGH PROPERLY SECURED 1X BUCK TO CONCRETE/MASONRY, OR DIRECTLY INTO CONCRETE/MASONRY, USE 3/16 INCH DIAMETER ITW TAPCON OF SUFFICIENT LENGTH TO ACHIEVE 11/4 INCH MINIMUM EMBEDMENT.
- MINIMUM EMBEDMENT AND EDGE DISTANCE **EXCLUDE WALL FINISHES, INCLUDING BUT NOT** LIMITED TO STUCCO, FOAM, BRICK VENEER, AND
- INSTALLATION ANCHORS AND ASSOCIATED HARDWARE MUST BE MADE OF CORROSION **RESISTANT MATERIAL OR HAVE A CORROSION** RESISTANT COATING.
- FOR GROUT FILLED BLOCK, DO NOT INSTALL INSTALLATION ANCHORS INTO MORTAR JOINTS. **EDGE DISTANCE IS MEASURED FROM FREE EDGE OF** BLOCK OR EDGE OF MORTAR JOINT INTO FACE SHELL 5. OF BLOCK.
- 11. INSTALLATION ANCHORS SHALL BE INSTALLED IN ACCORDANCE WITH ANCHOR MANUFACTURER'S INSTALLATION INSTRUCTIONS, AND ANCHORS SHALL NOT BE USED IN SUBSTRATES WITH STRENGTHS LESS THAN THE MINIMUM STRENGTH SPECIFIED BY THE ANCHOR MANUFACTURER.
- 12. INSTALLATION ANCHOR CAPACITIES FOR PRODUCTS HEREIN ARE BASED ON SUBSTRATE MATERIALS WITH THE FOLLOWING PROPERTIES: A. WOOD - MINIMUM SPECIFIC GRAVITY OF 0.55 (FOR SILL INSTALLATION ONLY).
 - B. CONCRETE -MINIMUM COMPRESSIVE STRENGTH OF 3000 PSI.
 - C. MASONRY STRENGTH CONFORMANCE TO ASTM C-90, GRADE N, TYPE 1 (OR GREATER).

QUALITY ENGINEERED PRODUCTS

SINGLE FLUSH DOOR (OUTSWING)

GENERAL NOTES:

- THE PRODUCT SHOWN HEREIN IS DESIGNED AND MANUFACTURED TO COMPLY WITH THE 2007 FLORIDA BUILDING CODE (FBC), INCLUDING **HVHZ AND HAS BEEN EVALUATED ACCORDING** TO THE FOLLOWING:
 - TAS 201-94/TAS 202-94/TAS 203-94
- ADEQUACY OF THE EXISTING STRUCTURAL CONCRETE/MASONRY AS A MAIN WIND FORCE RESISTING SYSTEM CAPABLE OF WITHSTANDING AND TRANSFERRING APPLIED PRODUCT LOADS TO THE FOUNDATION IS THE RESPONSIBILITY OF THE ENGINEER OR ARCHITECT OF RECORD FOR THE PROJECT OF INSTALLATION.
- THE INSTALLATION DETAILS DESCRIBED HEREIN ARE GENERIC AND MAY NOT REFLECT ACTUAL CONDITIONS FOR A SPECIFIC SITE. IF SITE CONDITIONS CAUSE INSTALLATION TO DEVIATE FROM THE REQUIREMENTS DETAILED HEREIN, A LICENSED ENGINEER OR ARCHITECT SHALL PREPARE SITE SPECIFIC DOCUMENTS FOR USE WITH THIS DOCUMENT FOR NON-HVHZ. ONE TIME APPROVAL REQUIRES FOR HVHZ FROM MIAMI-DADE COUNTY.
- THIS PRODUCT IS LARGE AND SMALL MISSILE IMPACT RESISTANT APPROVED IMPACT PROTECTIVE SYSTEM IS NOT REQUIRED ON THIS PRODUCT IN AREAS REQUIRING IMPACT RESISTANCE.
- DOOR FRAME MATERIAL: STEEL
- DESIGNATIONS "X" FOLLOWING:

TABLE OF CONTENTS

۸.	OPERABLE PAINEL	

5"	40.00" MAX. FRAME WIDTH 35.75" MAX. DOOR LEAF WIDTH A E 2 3	1/2" DIA. DYNABOLT ITW/REDHEAD SLEEVE ANCHOR (3/8" DIA. BOLT) X 4-1/2" SLEEVE ANCHOR W/ 3/4" DIA. WELDED PIPE SLEEVE W/ 1-7/8" MIN. EMBEDMENT & 3" MIN. EDGE DISTANCE OR (4) STEEL "T" ANCHORS
86.0" MAX. FRAME HEIGHT 83.5" MAX. DOOR LEAF HEIGHT 69.5"	6	24" MAX. O.C. TYP. 24" MAX. O.C. TYP. 38.0" 24" MAX. O.C. TYP.
<u></u>	UTSWING DOOR NTERIOR VIEW)	8.0"MAX. FROM CORNER #10 x 2" WOOD SCREWS WITH SHIELD SET AT 12" O.C. (EMBED INTO WOOD W/ 1.375" MIN. PENETRATION) OR 3/16" x 2" TAPCON SET AT 12" O.C. (EMBED INTO CONCRETE W/ 1-1/4" MIN. PENETRATION)

SHEET	REVISION	SHEET DESCRIPTION
1	-	INSTALLATION & GENERAL NOTES
2	-	CYLINDRICAL LOCK SECTIONS
3	-	MORTISE LOCK SECTIONS
4	-	INTERNAL SECTIONS & DOOR DETAILS
5	-	ANCHOR DETAILS
6	-	STEEL REINFORCEMENTS
7	-	COMPONENTS & BILL OF MATERIALS

CYLINDRICAL LOCK SMALL AND LARGE NOT APPROVED +/- 80 PSF* MISSILE IMPACT RATED W/ STD. REINFORCED MORTISE LOCK W/ SMALL AND LARGE DEAD BOLT W/ HAT NOT APPROVED +/- 110 PSF* MISSILE IMPACT RATED REINFORCED

MIAMI DADE/FLORIDA BUILDING CODE DESIGN PRESSURES

WHERE A WATER

INFILTRATION REQUIREMENTS

IS NOT NEEDED

MISSILE IMPACT RATING

WHERE A WATER

INFILTRATION

REQUIREMENTS IS NEEDED

* UNIT SHALL BE INSTALLED AT LOCATION PROTECTED BY OVERHANG SUCH THAT OVERHANG RATIO (OH) = OH LENGTH/OH HEIGHT IS GREATER THAN 1

4506 QUALITY LN. TAMPA, FL. 33634 PH: (813) 885-1693 FX: (813) 884-2673 QUALITY æ 20 SI

 $\overline{\alpha}$


Š


Products Co., Inc.


ipproved as complying with the Florida Buiding Code Date DEC 30, 2009 NOA# 09-0604-10


DWG #:


SHEET:

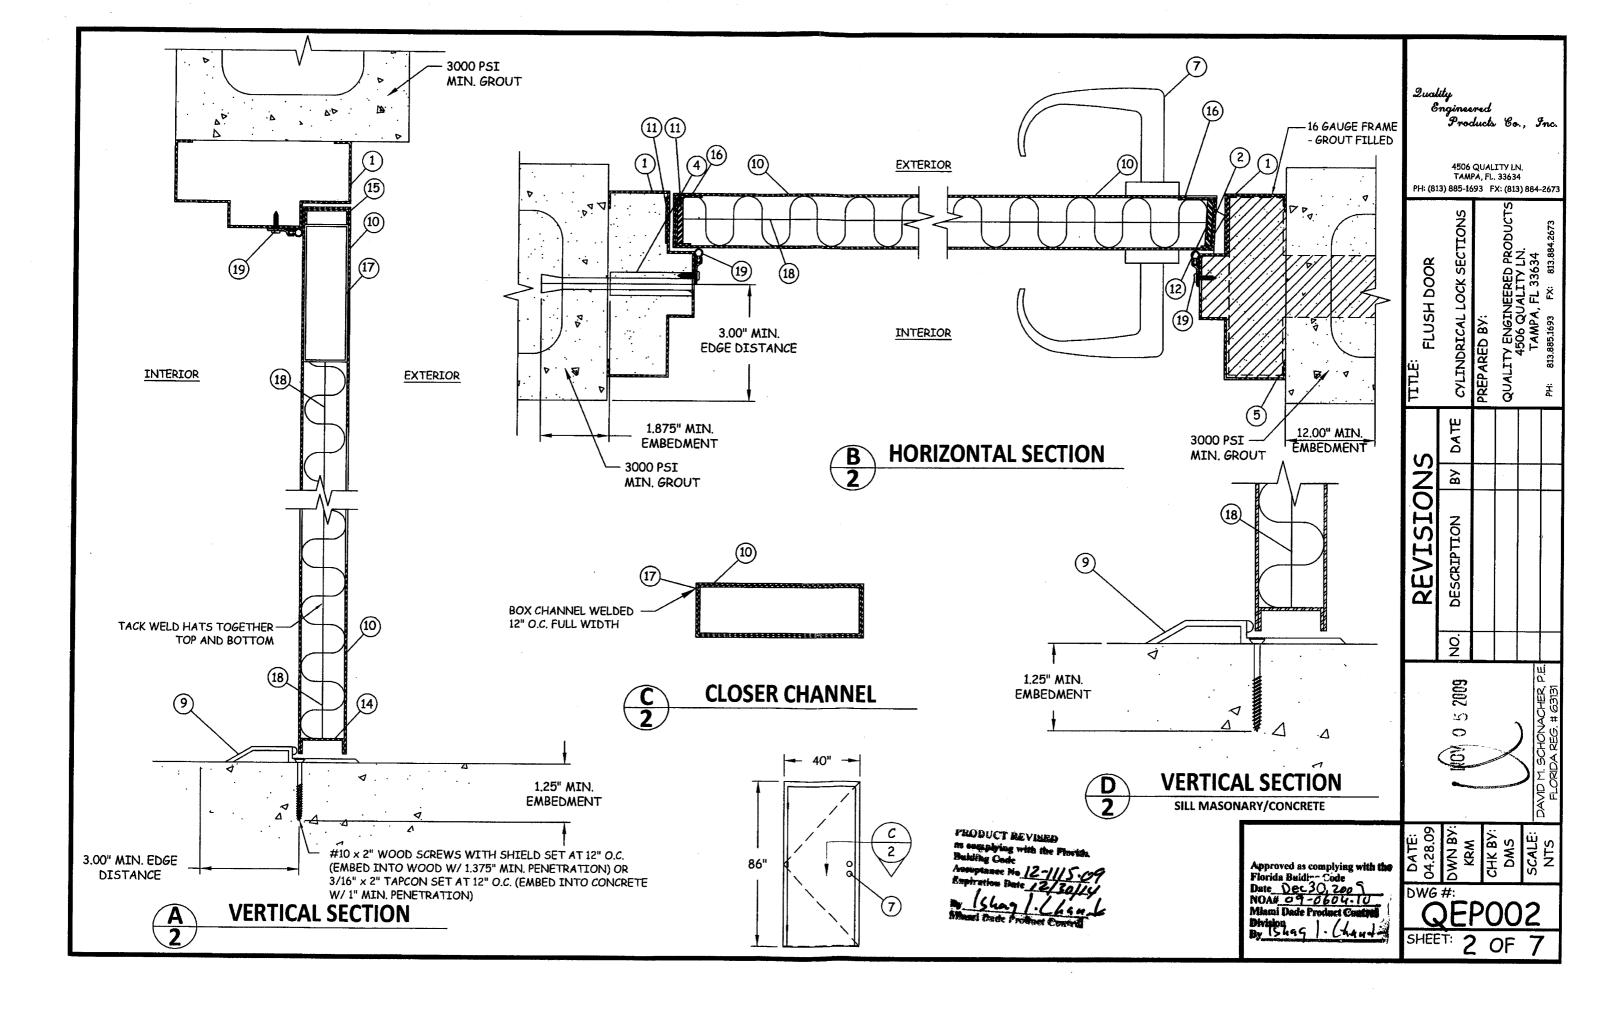


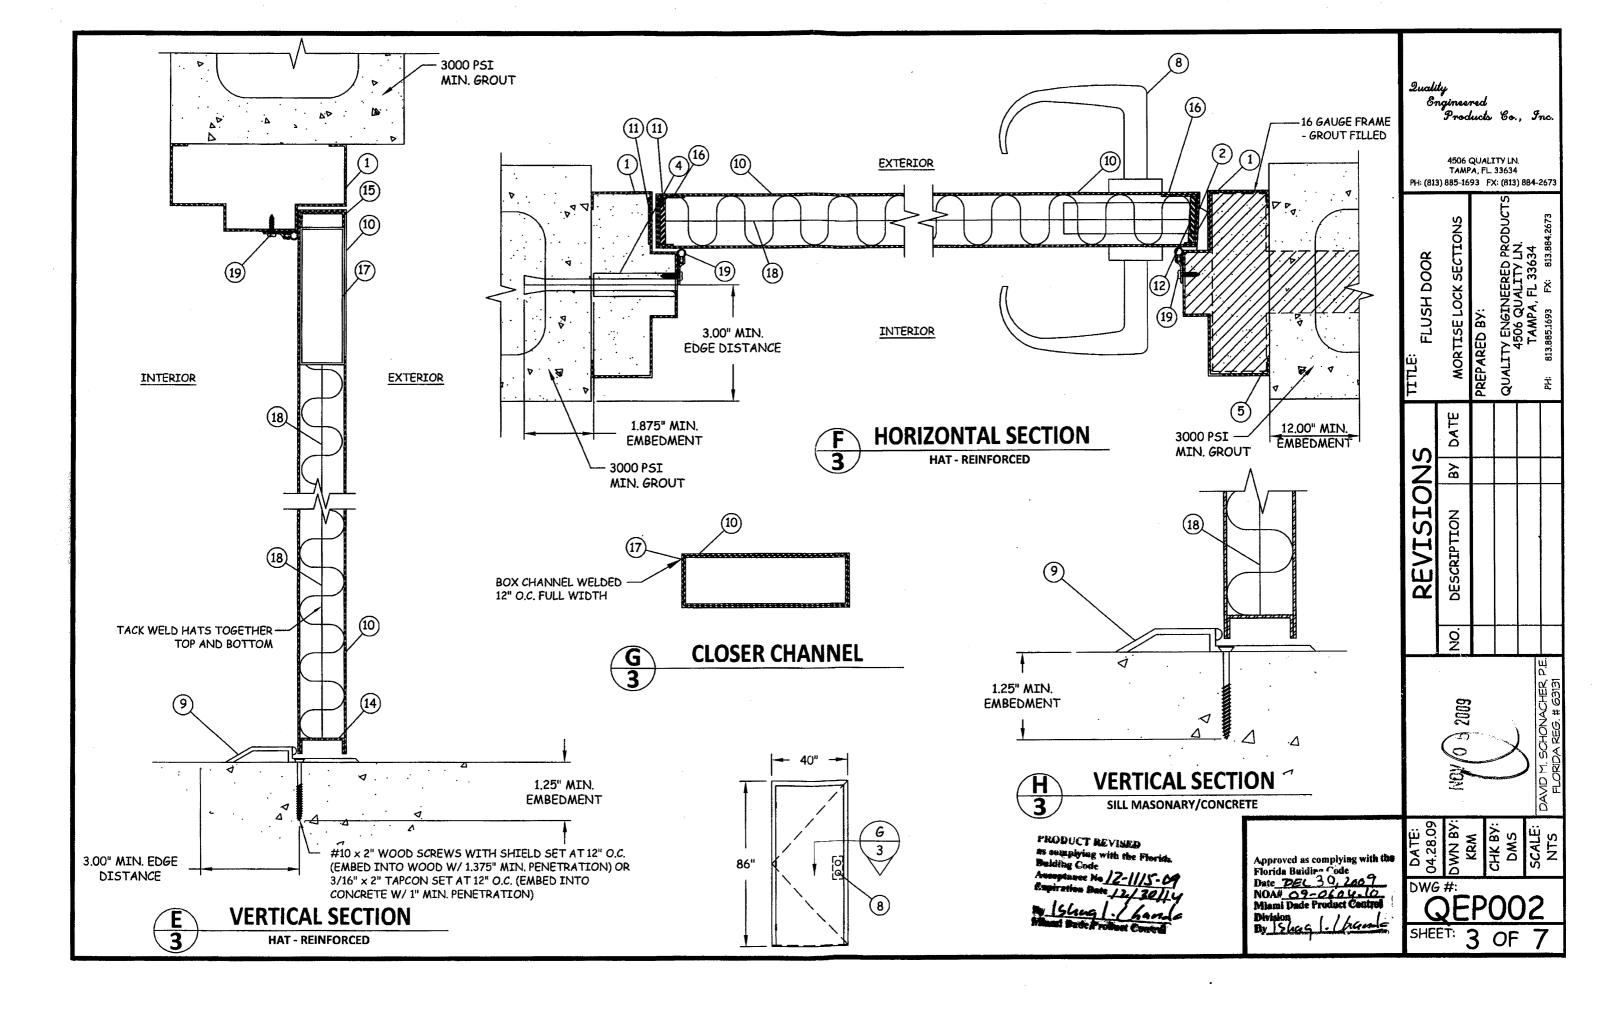


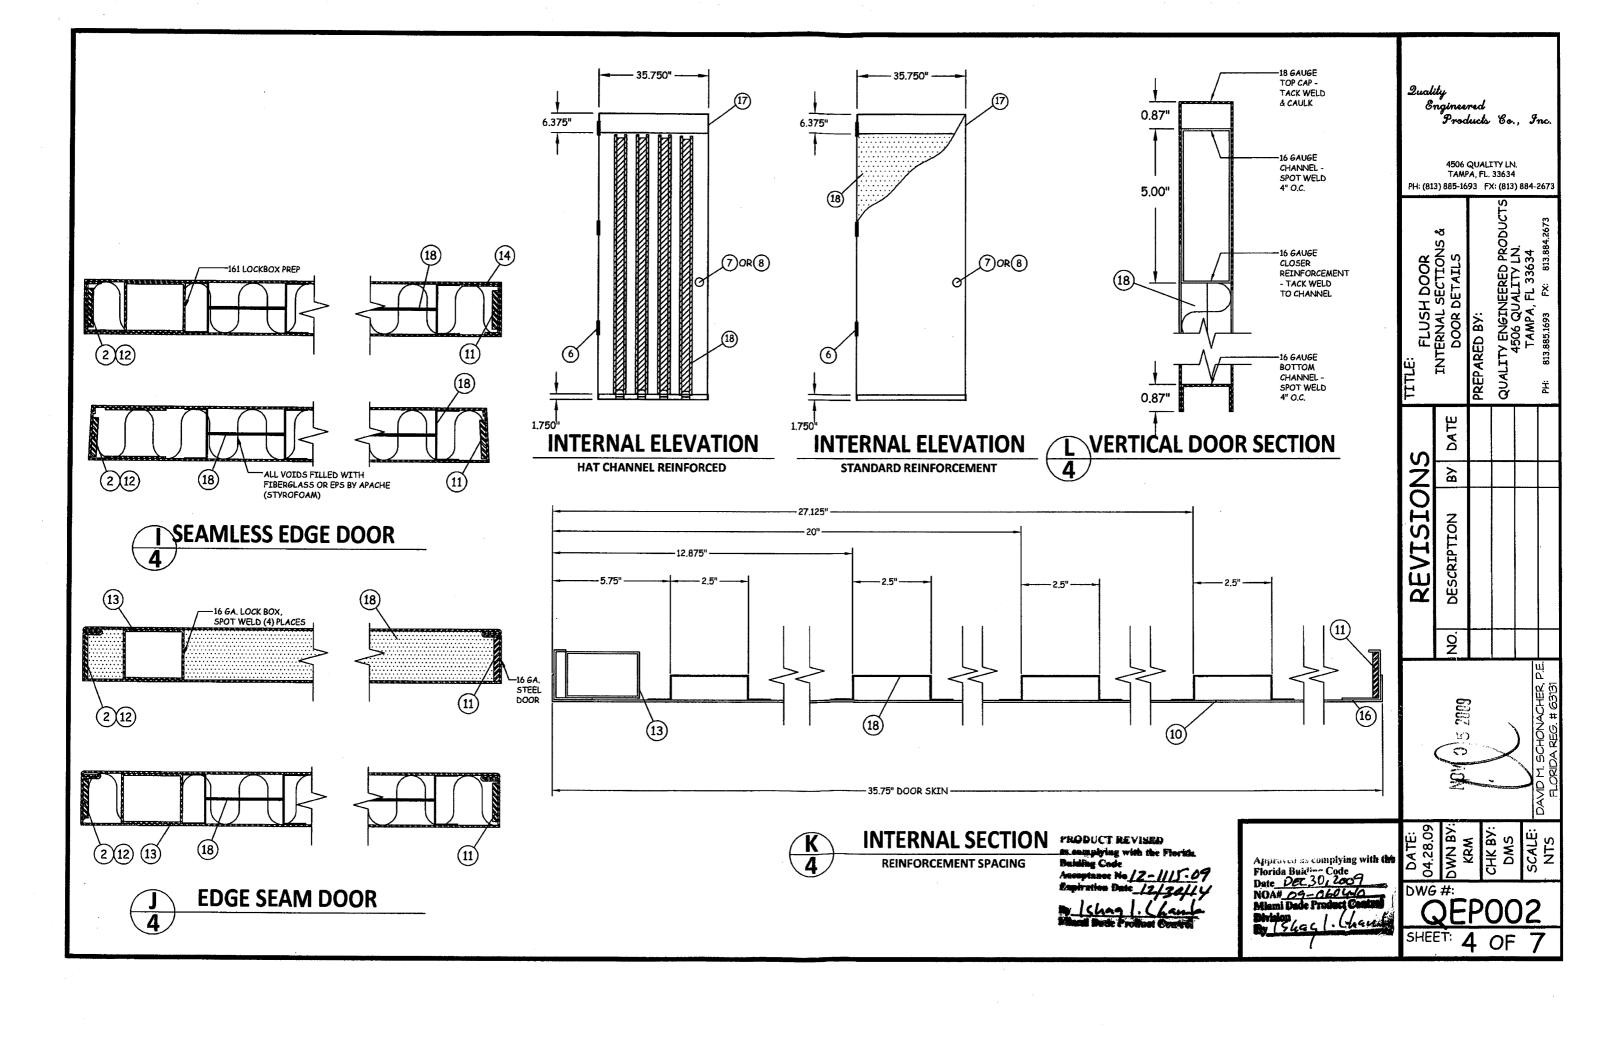

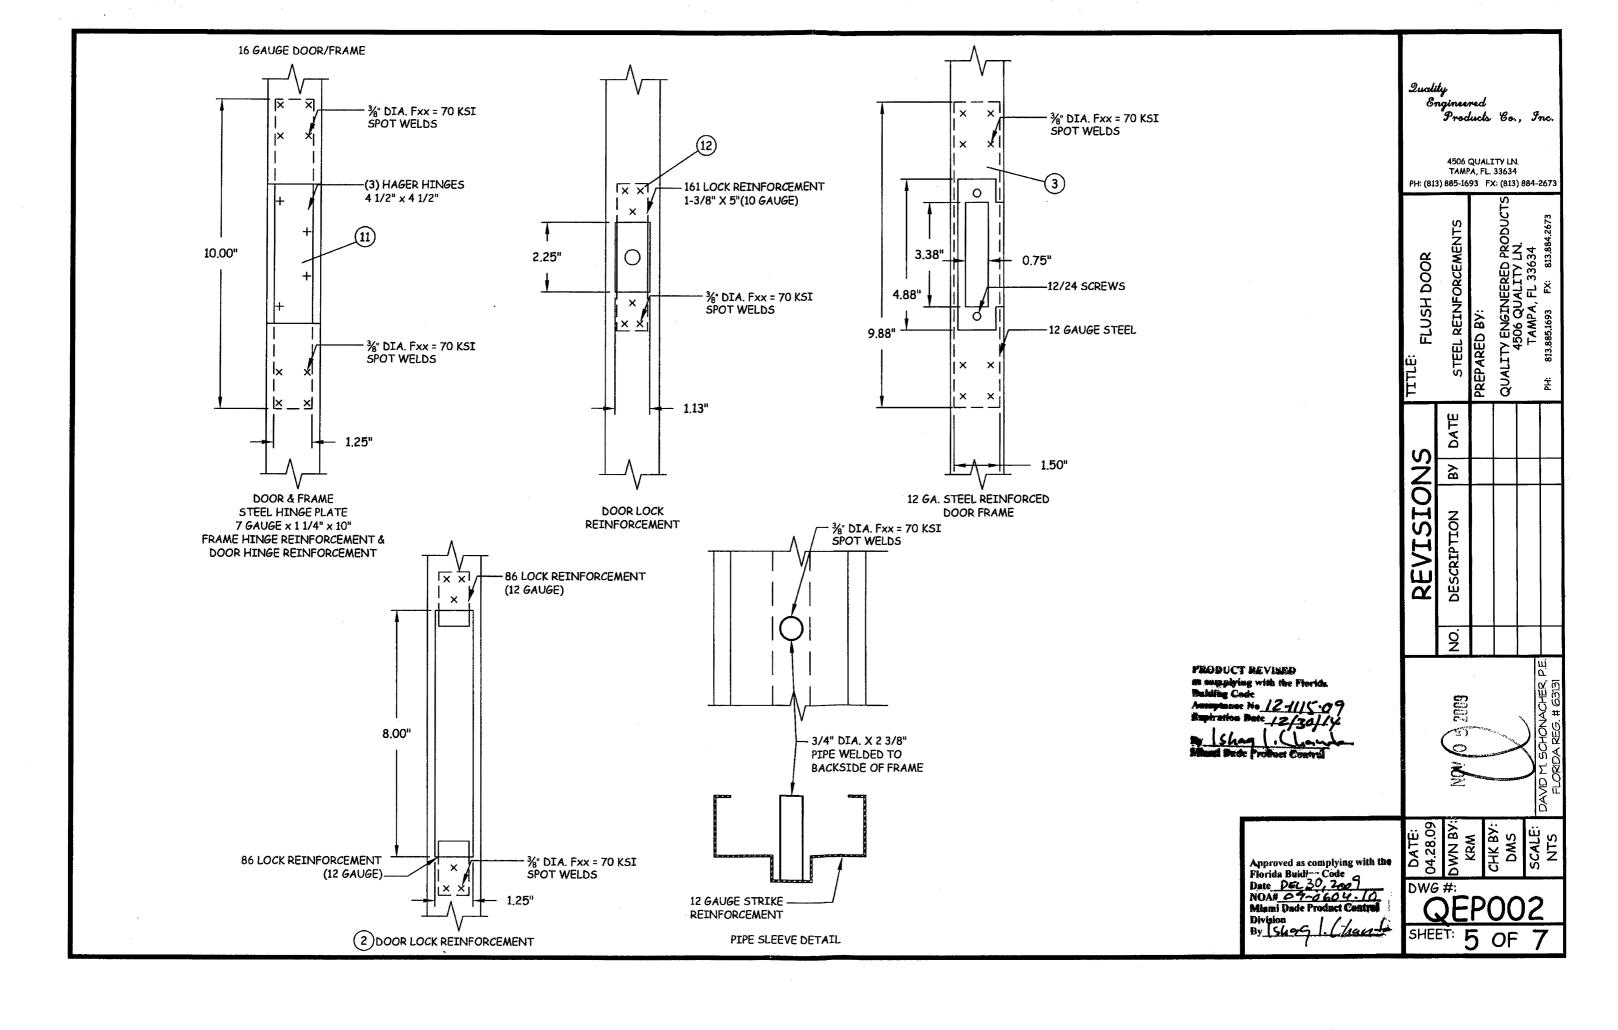


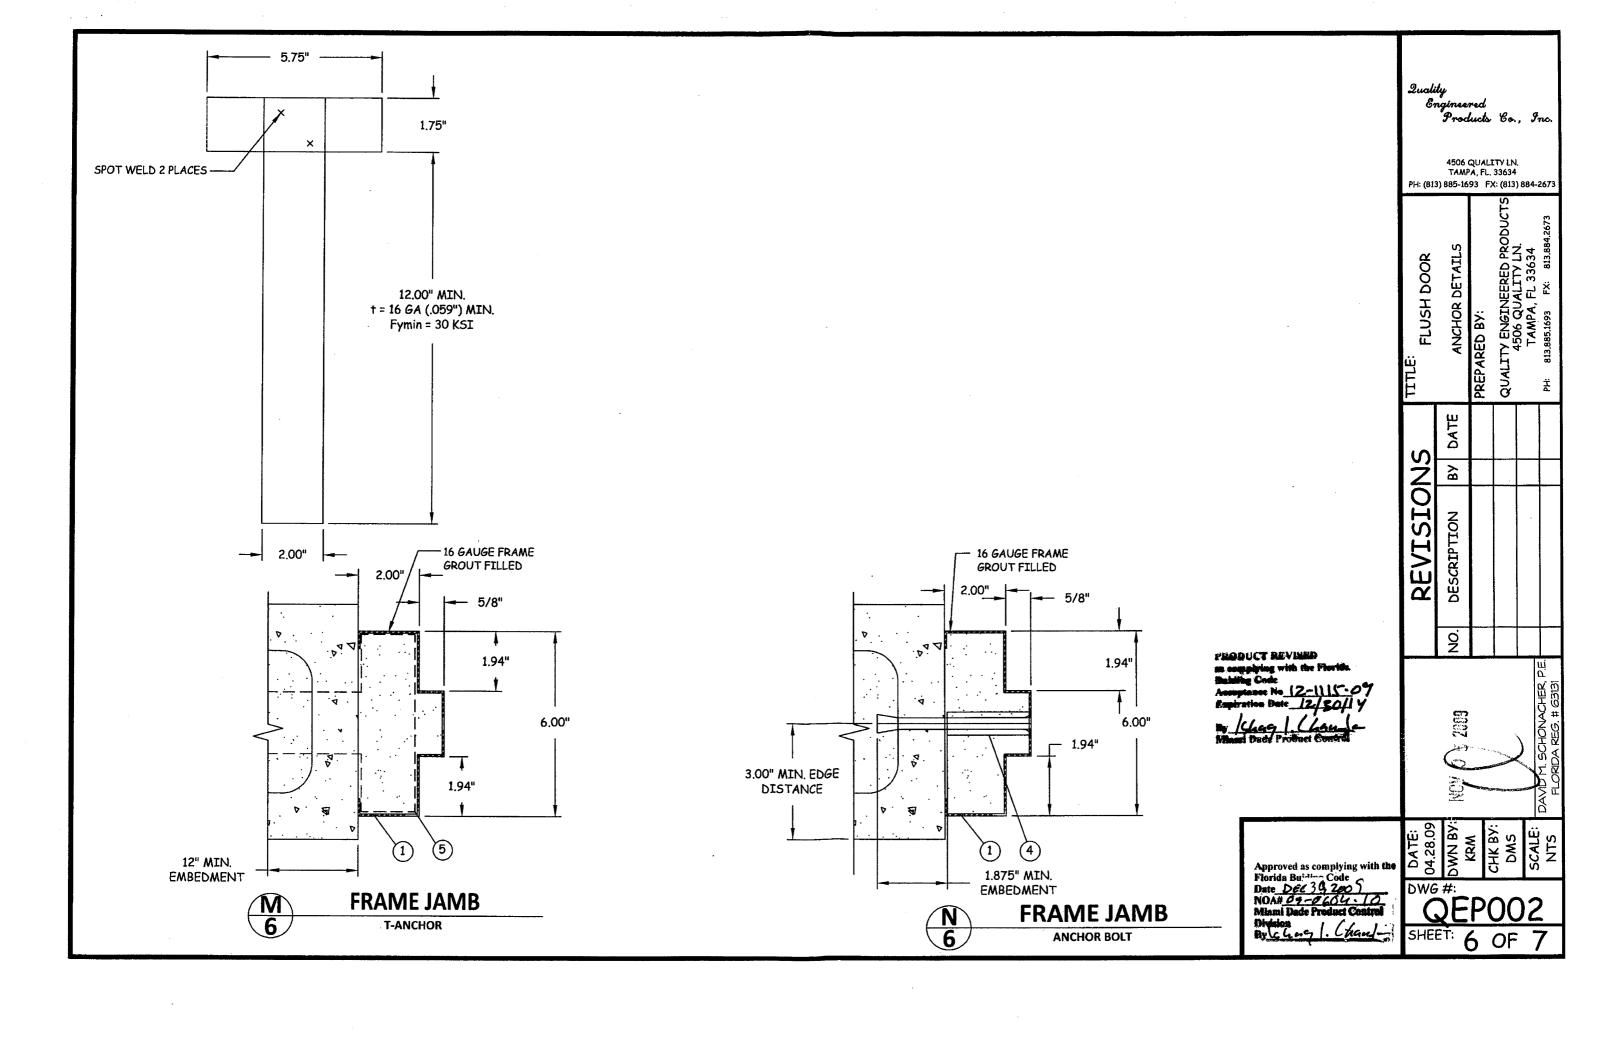

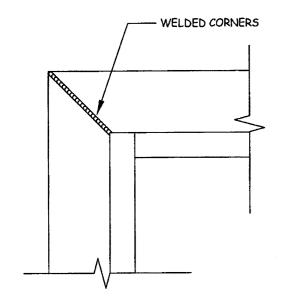

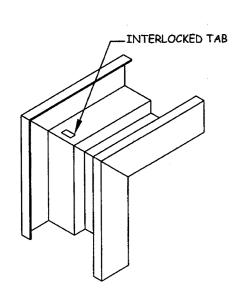

BILL OF MATERIALS				
MARK				
1	16 GAUGE STEEL FRAME W/ GROUTED JAMBS			
2	11/8" X 21/2" X 12 GA. STEEL LOCK OR STRIKE REINFORCEMENT			
3	1½" x 8" x 12 GA. FRAME STRIKE REINFORCEMENTS			
4	½" DIA. DYNABOLT ITW/REDHEAD SLEEVE ANCHOR (¾" DIA. BOLT) X 4½" SLEEVE ANCHOR W/ ¾" DIA. WELDED PIPE SLEEVE W/ 1¾" MIN. EMBEDMENT & 3" MIN. EDGE DISTANCE			
5 T-ANCHORS PER DETAIL SHEET6				
6	HAGER HINGES BB1279 4.5 X 4.5 X .134 THICK			
7	MARKS 195 SERIES, SCHLAGE D SERIES OR BEST 93K (CYLINDRICAL)			
8 SCHLAGE L9000 SERIES MORTISE LOCK				
9	9 PEMKO 2001av THRESHOLD			
10				
11	11/4" X 10" X 7 GA.STEEL HINGE REINFORCEMENT			
12	1%" x 5" x 10 GA. LATCH REINFORCEMENT			
13	16 GAUGE LOCK BODY REINFORCEMENT (16 GAUGE PLATE AT MORTISE LOCKS)			
14	U-SHAPE END STEEL CHANNEL			
15	U-SHAPE CLOSE TOP STEEL CHANNEL			
16	11/4" x 11/8" x 1/8" FULL LENGTH STEEL CHANNEL			
17	11/2" x 51/4" 12 GA. STEEL BOX CHANNEL WELDED 6" O.C. FULL LENGTH			
18	20 GAUGE HAT STIFFENERS 74" LONG W/ FIBERGLASS INSULATION OR POLYSTYRENE FOAM BY DYNAPLAST (FOAM APACHE PZOD) PER CURRENT NOA.			
19	PEMKO 303AS WEATHER STRIP			

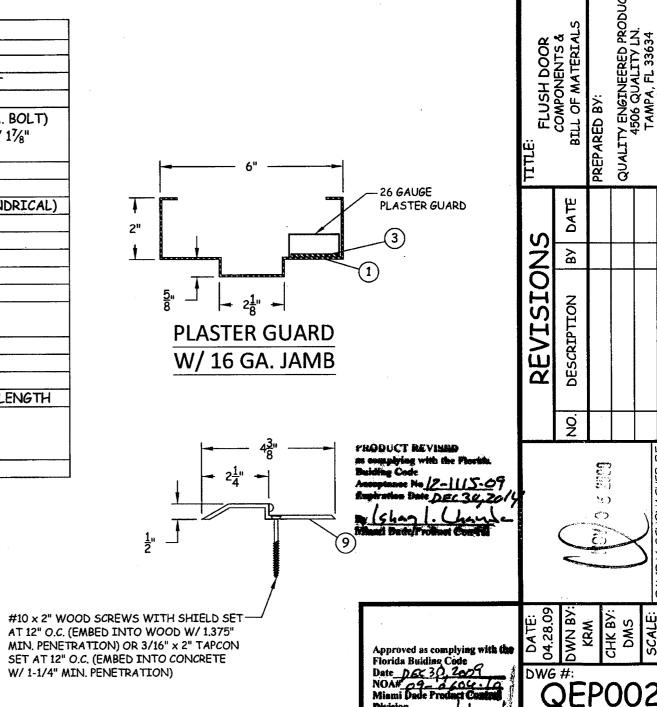

4506 QUALITY LN. TAMPA, FL. 33634 PH: (813) 885-1693 FX: (813) 884-2673